



New Cage Layout (Overall Dimensions & Location)

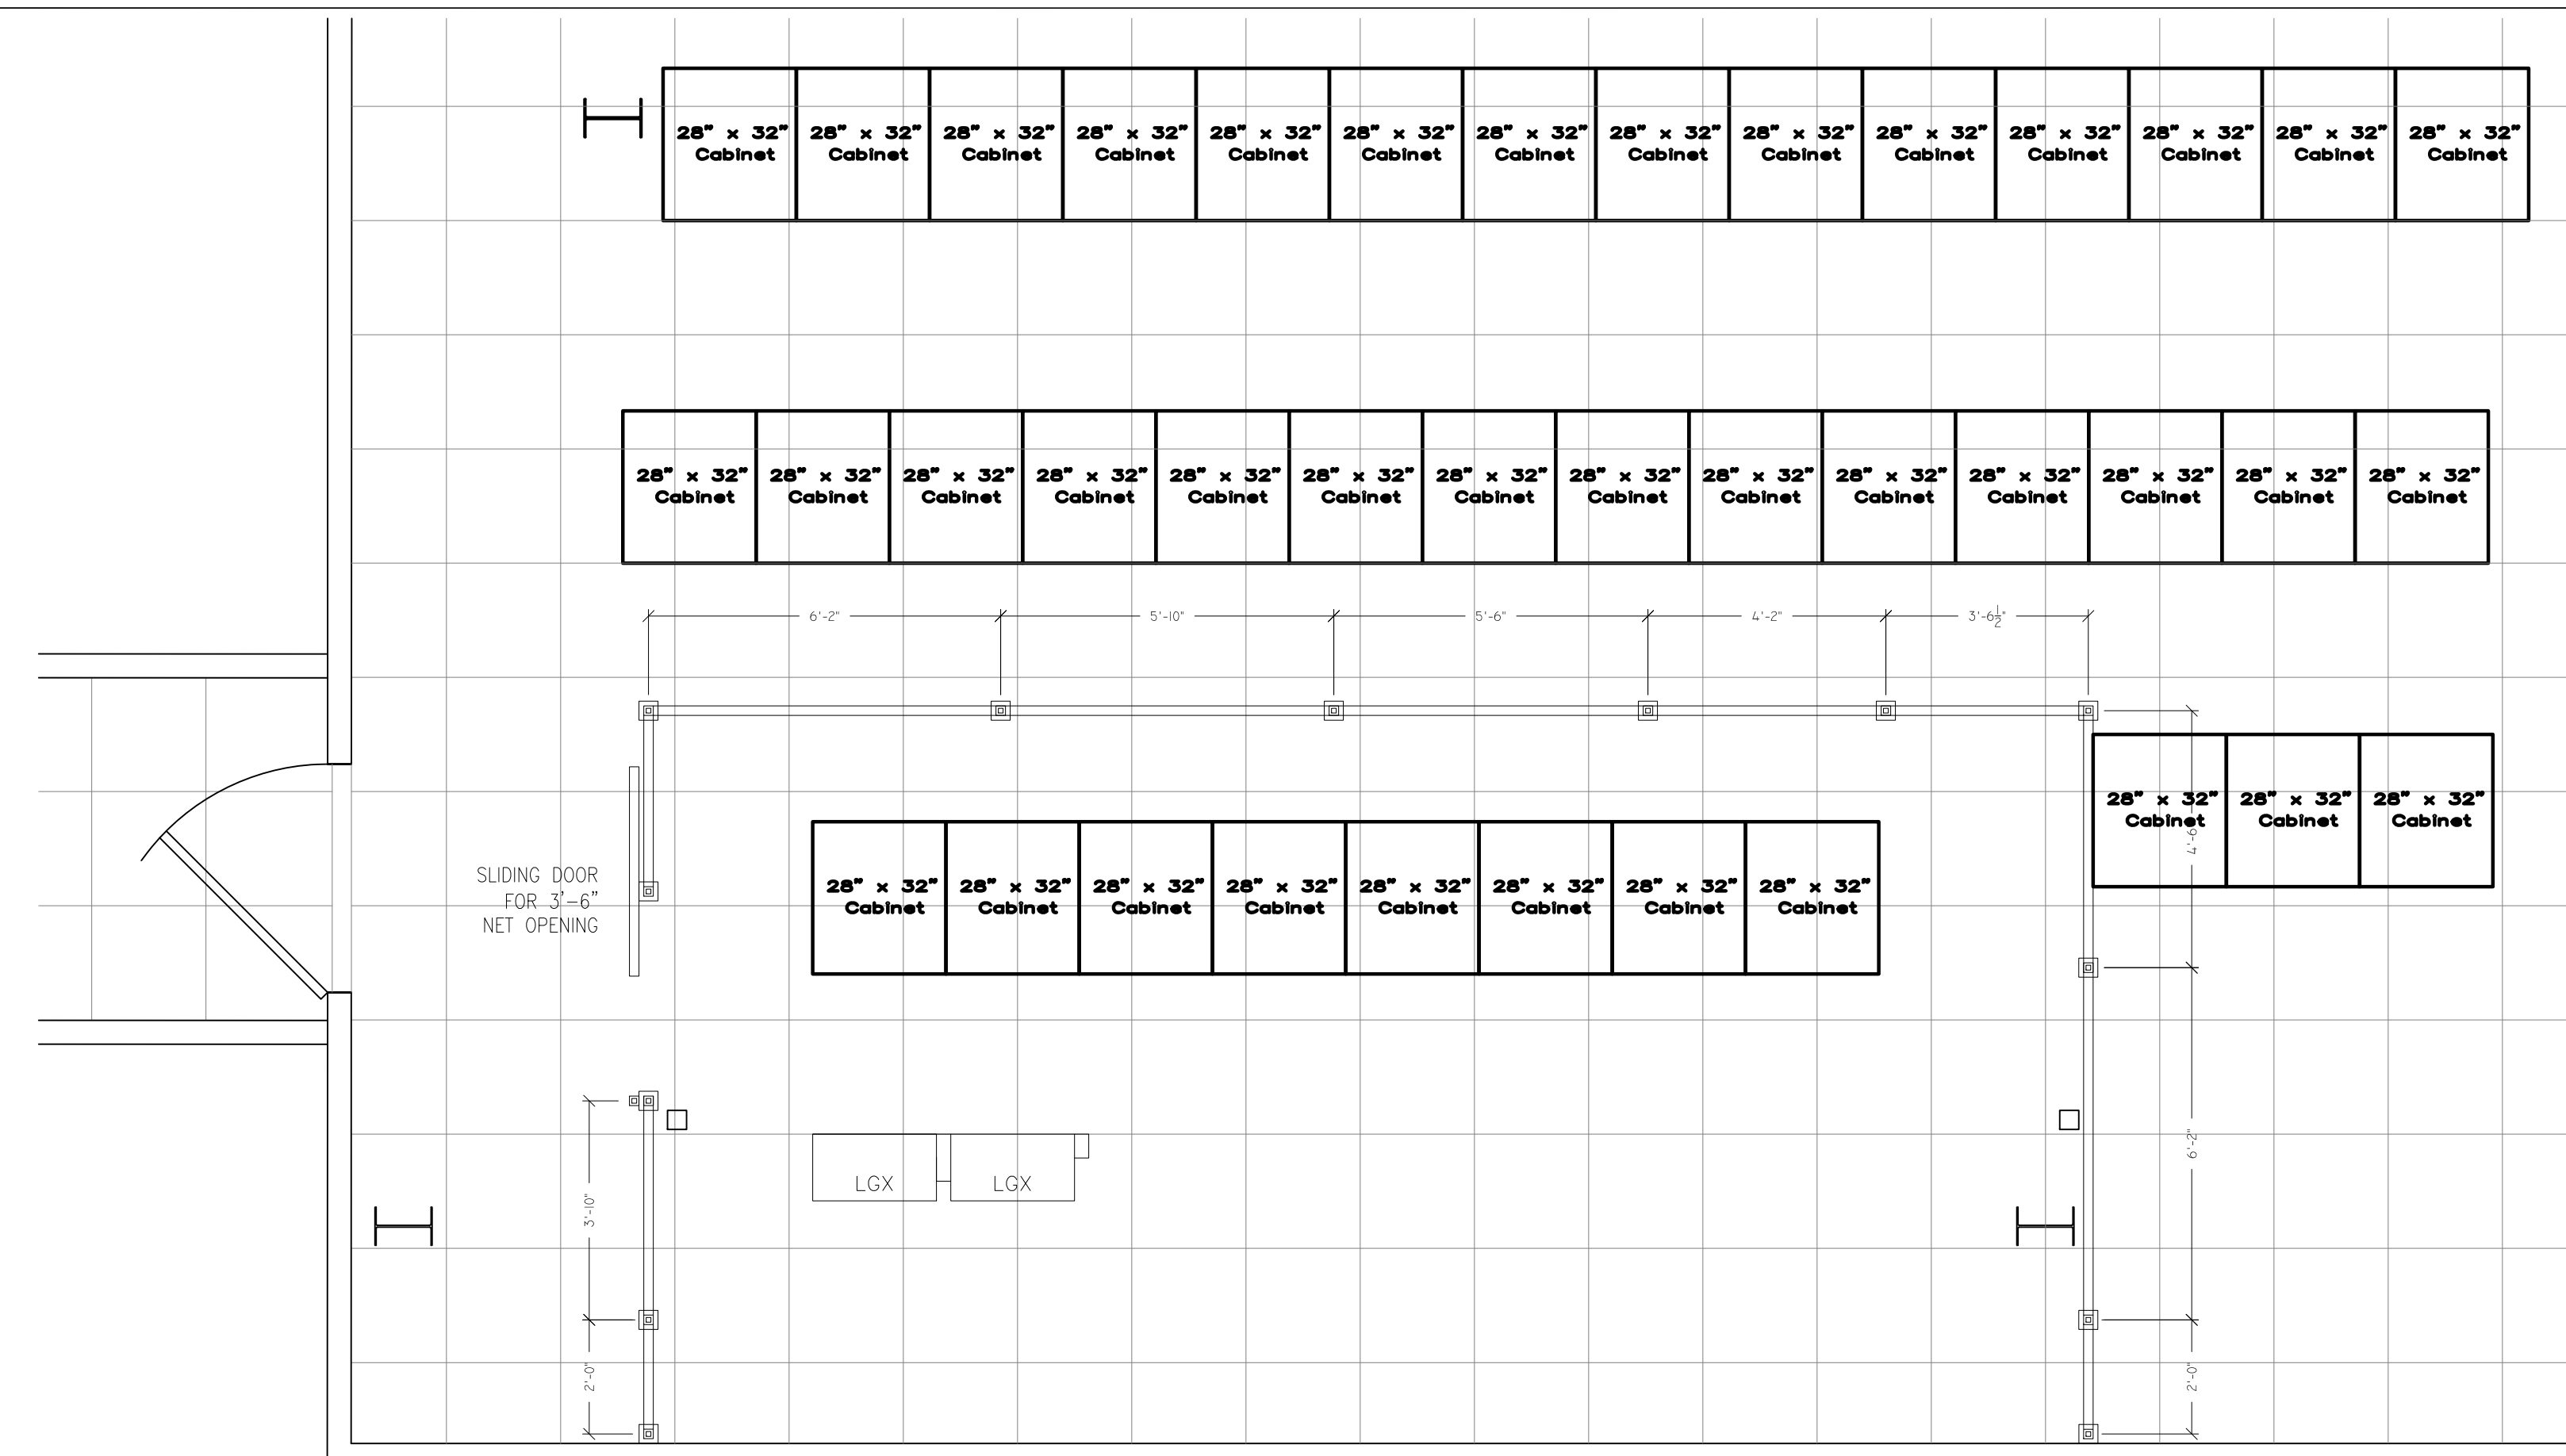

New Cage Layout (Pole Locations On Floor)

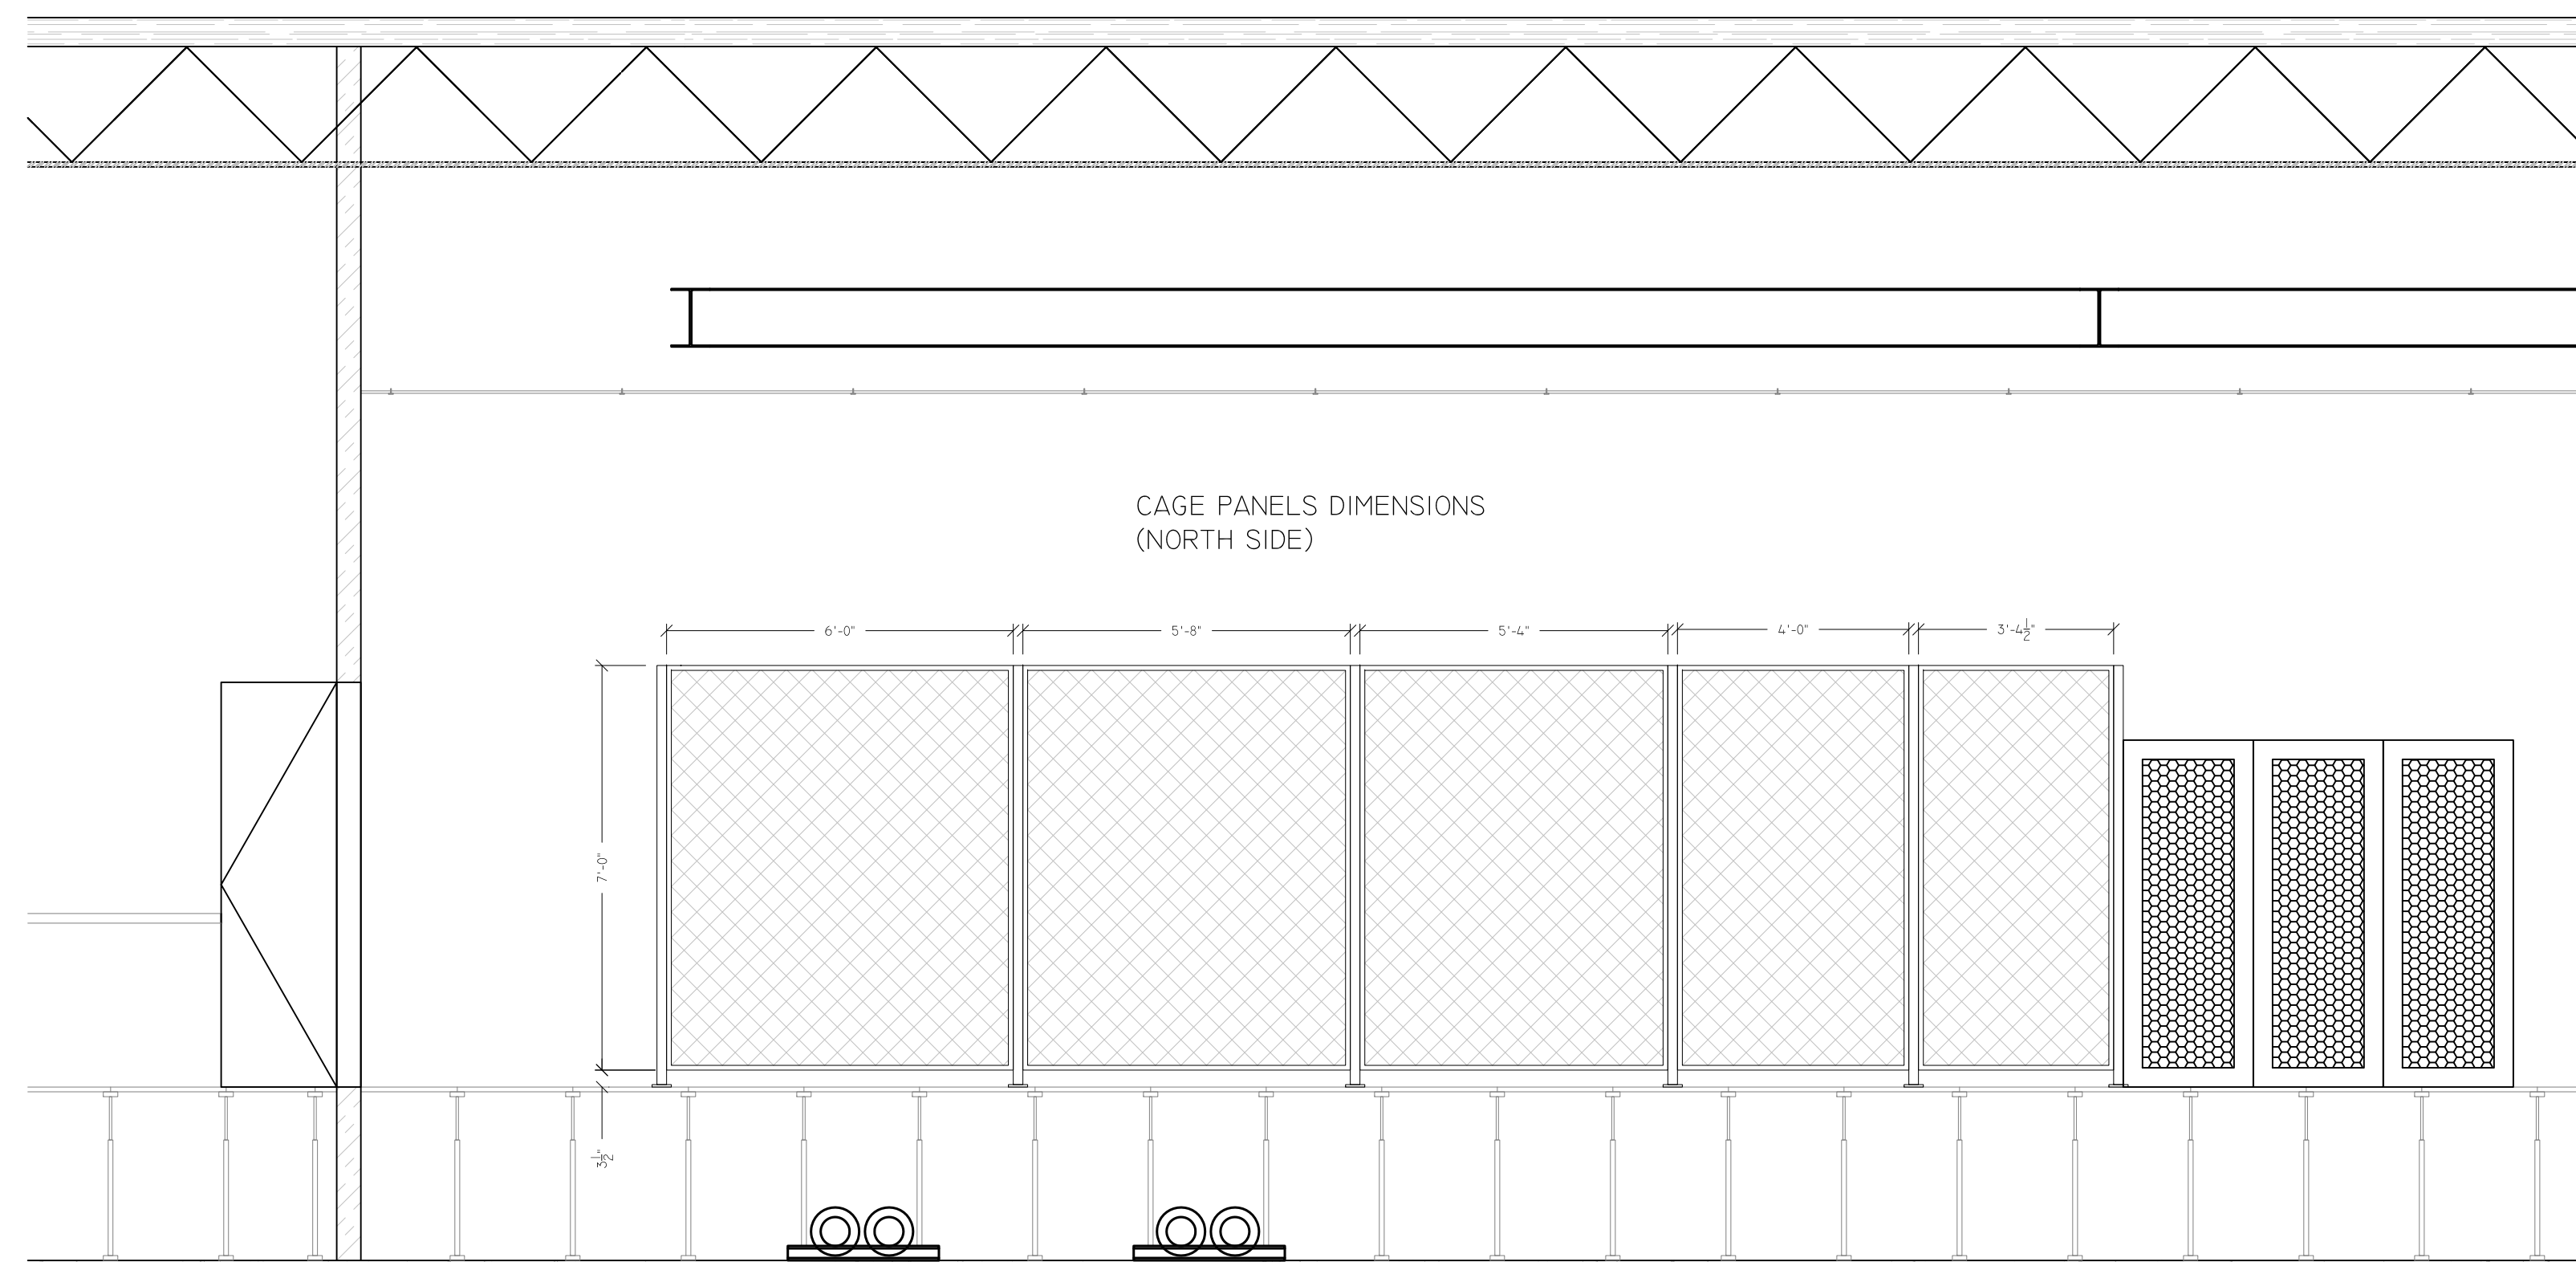

Elevation View For Cage Installation & Panel Section Details For North Side

NOTES:

1. CAGE PANELS MUST BE 3-1/2" ABOVE FLOOR LEVEL.
2. CAGE POLES MUST BE PLACED ON SINGLE RAISED FLOOR TILE.
3. THE SLIDING DOOR SHALL PROVIDE NET 3'-6" OPENING & SHALL NOT PASS CAGE LIMITS (WHEN DOOR IS OPEN).
4. ON SOUTH WALL, CAGE PANELS SHALL NOT BE ATTACHED TO WALL.

TR	DATE	REVISION DESCRIPTION	BY
-	03/15/11	As Built	AG



AllCom Global Services, Inc.
201 Stag Industrial Blvd., Lake St. Louis, MO 63367
[P] 636.625.1717 [F] 636.625.6177



5524 Bee Caves Rd., Suite C-1, Austin, TX 78746
Phone: 512-328-2461
web: www.catvdesign.com



MGI NETWORK SERVICES, LLC.
2900 Longhorn Blvd., Suite 101, Austin, TX 78758
Tel: 512-795-9055 Fax: 512-491-7657
web: www.mginetworkservices.com



185 Ridgedale Avenue, Cedar Knolls, NJ 07927
Tel: 973-889-1101 Fax: 973-889-1170
e-mail: sa@sullivanusa.com

AKIN GOGUS
PROFESSIONAL ENGINEER
SULLIVAN ASSOCIATES
NJ GE048363

Project Name:
CARTERET DATA CENTER
14 Self Blvd., Carteret, NJ

Drawing Title:
Security Cage Installation Details, Dimensions & Notes

Drawn By:
A.G.
Checked By:
R.J.S.
Scale:
3/8"=1'-0"
Date:
07/14/2010

Project No.
Q10421-ALC

Drawing No.
M - 17